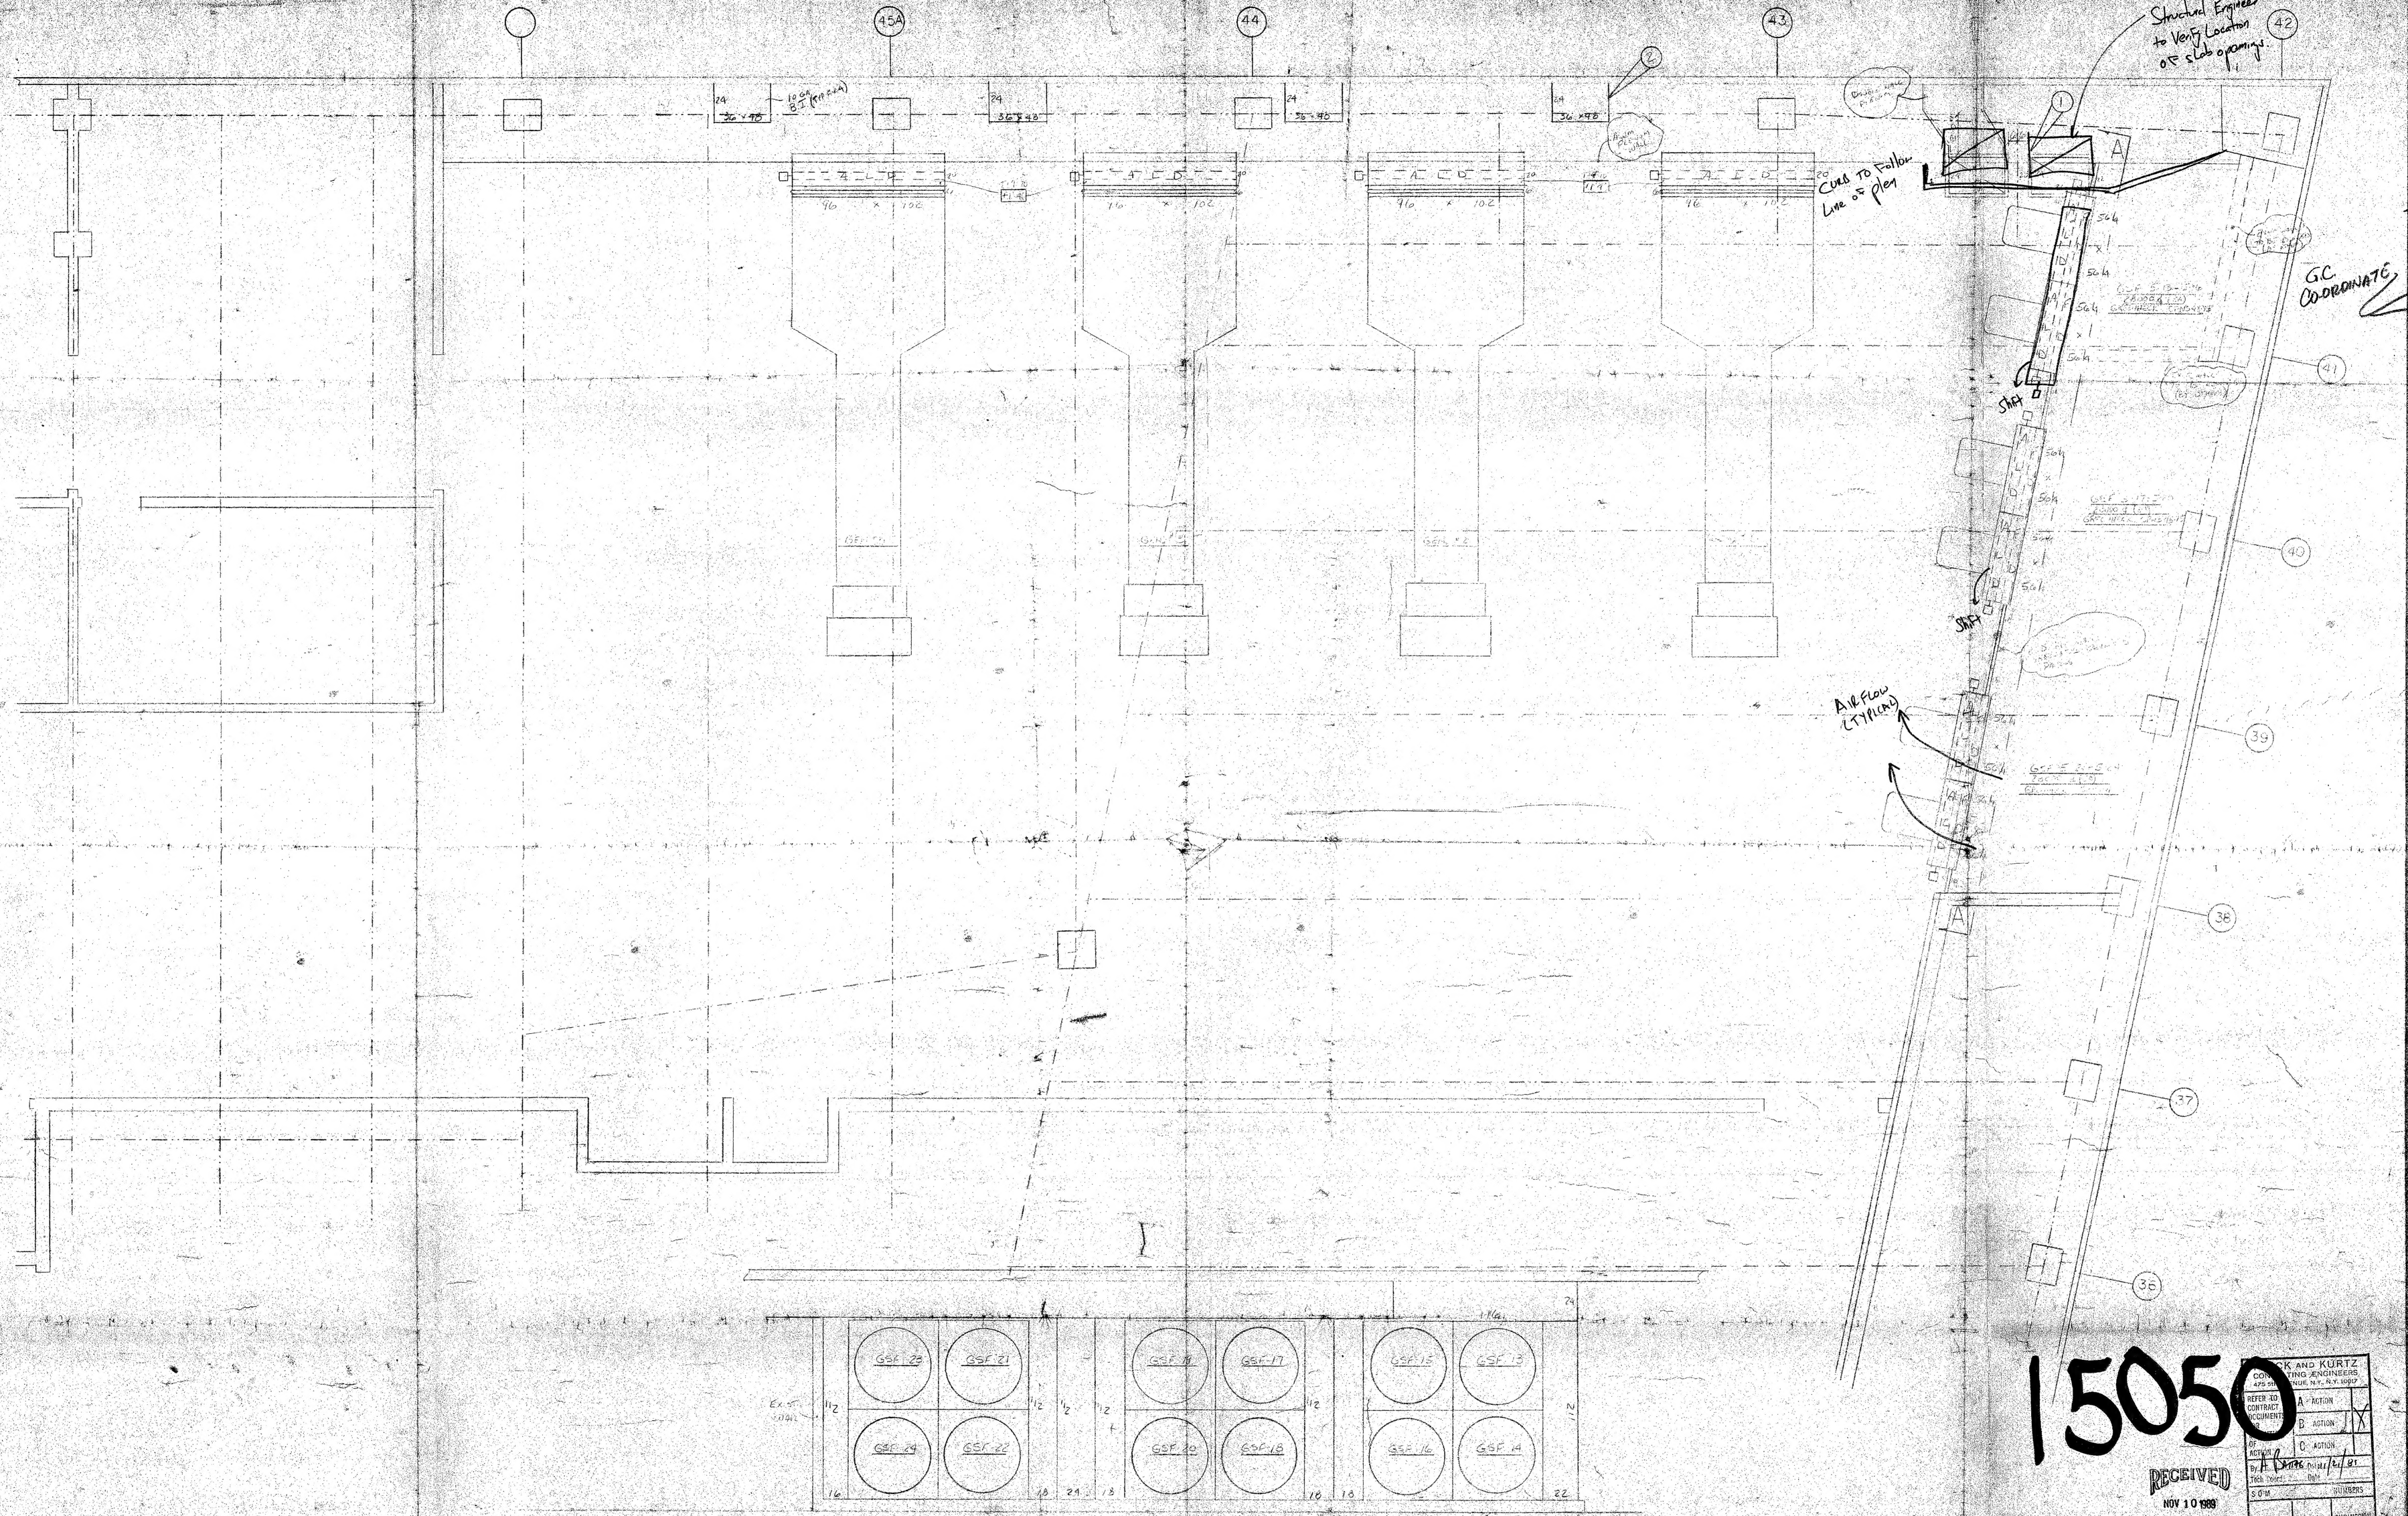

LEGEND OF SYMBOLS

ARCH. & ENGR. NOTES

THIS DRAWING CONTAINS
NO. TO

RELEASE NO.	DATE	PC NOS.

DRAWING: PLOT PLAN
REFERENCE DRAWINGS USED

DWG #	REV #	DATE	DWG #	REV #	DATE
A	3	7/1/87			
A	5	11/10/87			
M&P	5	11/10/87			

15050

98-1

RECEIVED
NOV 10 1988
FLACK & KURTZ
CONSULTING ENGINEERS
N.Y., N.Y.

FLACK AND KURTZ
CONSULTING ENGINEERS
NEW YORK, N.Y., N.Y. 10017

REFER TO CONTRACT CURRENCY
A - ACTION
B - ACTION
C - ACTION
BY Flack & Kurtz DATE 11/1/88
FILE NO. SUBMISSION
SECTION

SUBMITTED MATERIAL
APPROVED AS NOTED
DO NOT RELEASE FOR CONSTRUCTION
NEW YORK, N.Y.
DATE

NOV - 9 1988
MORSE/DIESEL

REVISIONS

MEP METALINE, INC.

PROJECT SALOMON BROS. INC.
7 W.T.C.
SHEET TITLE PLAN - SECTION - DETAILS
CONTRACTOR CENTRIFUGAL
ENGINEER FLACK & KURTZ
ARCHITECT SKIDMORE, OWINGS, MERRILL
SCALE 1/4" = 1'-0" DRAWN JF DATE 7/1/87
JOB NO. 868 DRWG NO. 5-3

WTC-3-5OM